



(T-OFF) NAEEN-KHOR
J1AR610

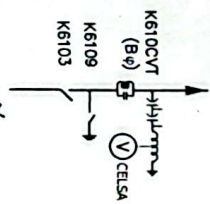


T2LA2

LVAC PANEL

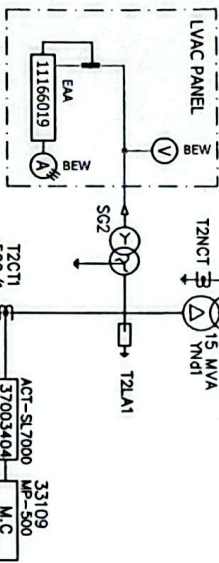

42BUS

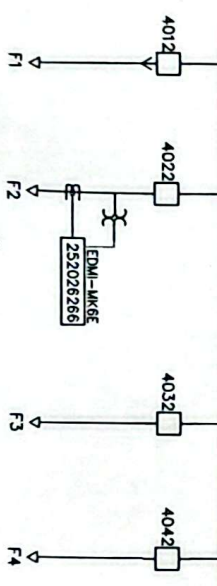

ENERGY METER SPECIFICATIONS					
ردیف	محل نصب	نیت تبدیل	نیت تبدیل	دف کل	دف کل
1	T1-20KV	CT	PT	0.2	0.2
2	LVAC	CT	PT	1 FSS	1 FSS
3	توربو گاز	CT	PT	0.2 FSS	0.2 FSS

- NOTE:
1. M.C : Measurement Center (MP-500)
 2. All Analog Voltmeter & Ammeter
Manufactured By "BEW OR CELSA"

نبرو گاه خورشیدی نو
اندیشان صنعت فولاد

AKHTAR BARGH CO.
AS BUILT
Date: ۱۴۰۴/۴/۱۱
Eng: امیر رحمانی

DATE: 1404-04-01	Design	Estadant	Title:	ANARAK 63/20 KV SUBSTATION	CONTRACTOR:	CONSULTANT:	CLIENT:	DRAWING NO:	990001	Page: 800
Draw.	Rhodadad	Khodadad	Draw.	MSLD SCHEMATIC DIAGRAM	Akhtar Bargh Co.		E.R.E.C	PROJECT NAME:	توربو گاز نیروی برق فولاد	Cont: ...
Checked	Kelayat	Estadant	Appr. 1	Mirzai				Rev: 4		